



Exhibition 1 - Proposed location of Immersive Experience
 Out of Project Scope
 Exhibition 1
 Exhibition 2

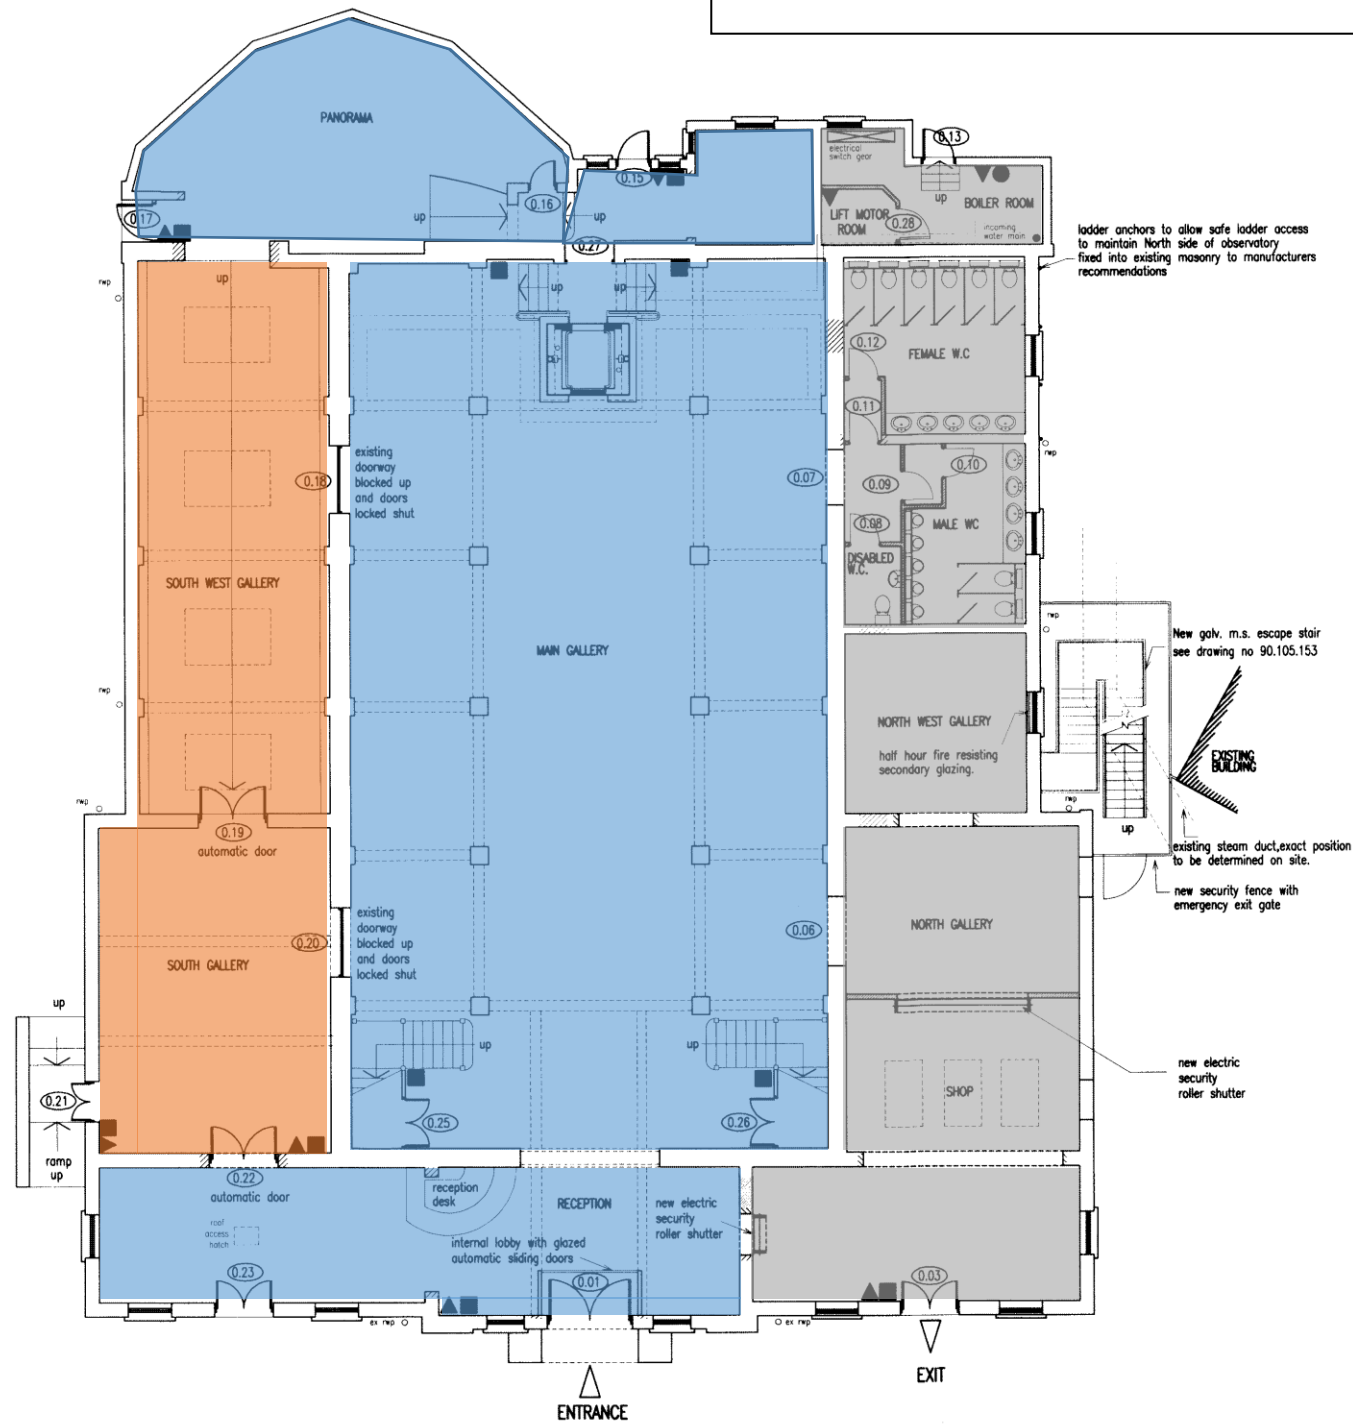

GROUND FLOOR PLAN

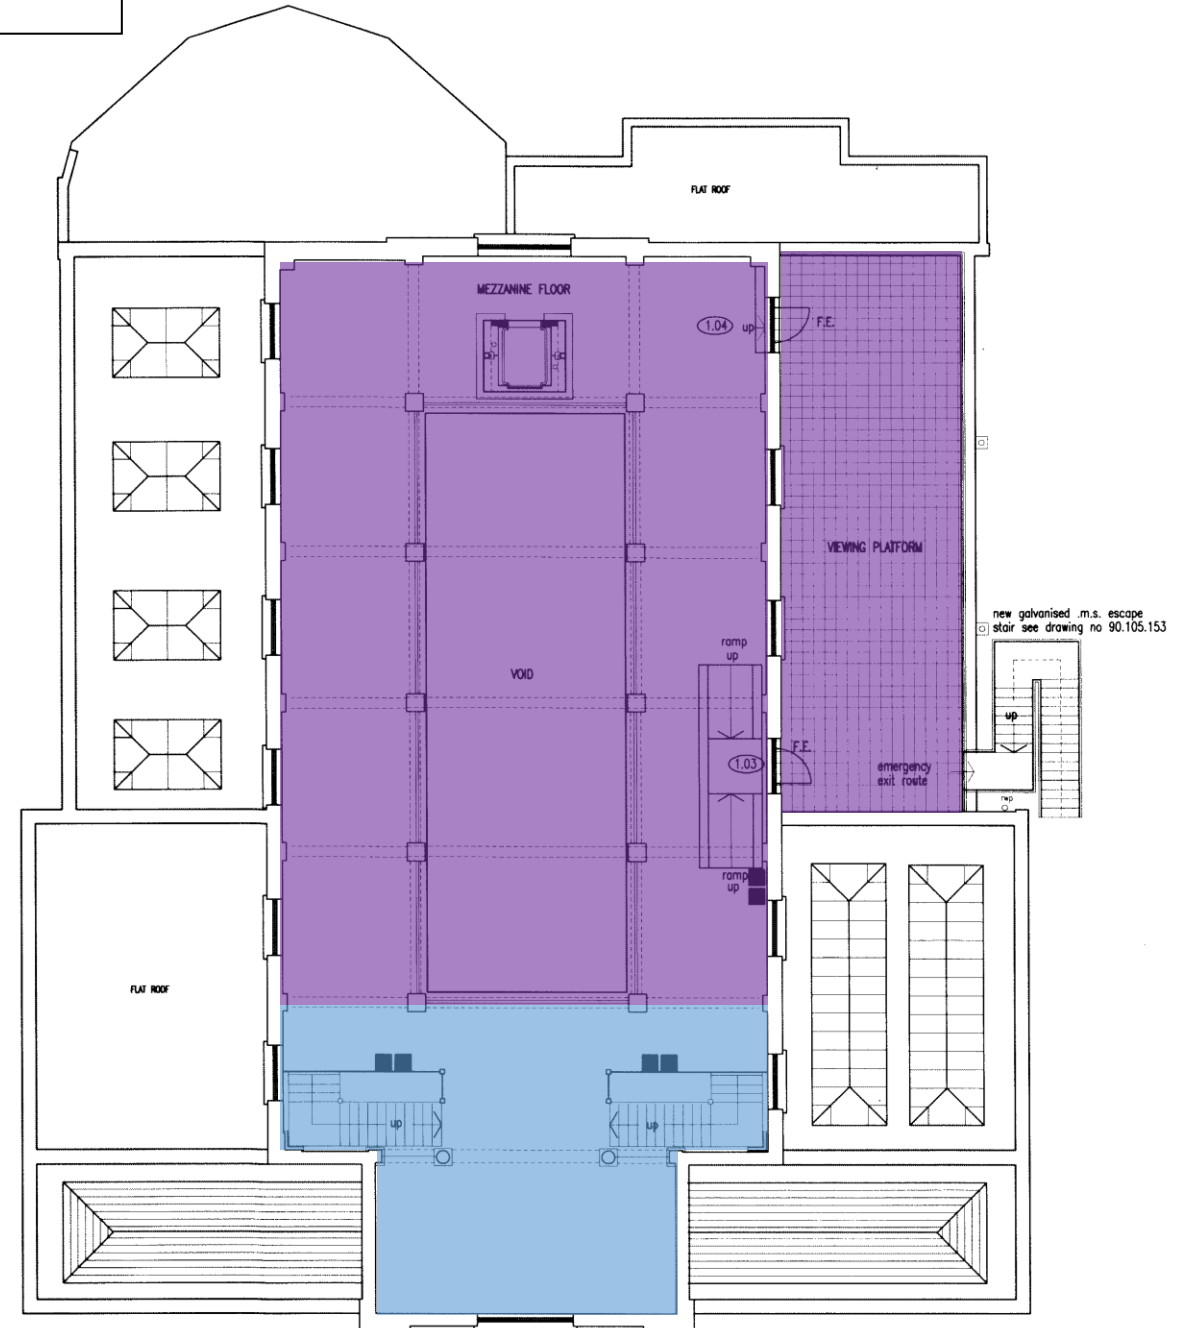

FIRST FLOOR PLAN

NOT TO SCALE – DO NOT SCALE FROM PLAN

- KEY
- ▲ EC20 2Kg CO2 x 8
 - EH 6Ltr HYDROSRPAY(Water) x 16
 - 9Kg DRY POWDER x 1

Note:
Equipment by Chubb Fire Ltd
Tel. 0181 844 1666

Rev	Date	Description	By	Chk
B	21.7.99	ISSUED FOR RECORD PURPOSES	fg	PH
A	25.04.99	Issued For Construction	fg	PH

RECORD DRAWING

HGP Greenlee Alchurch Evans Ltd.
© Copyright Reserved 1999.
Do not scale - check dims. on site.

Drawn by: fgh
Checked by:

Drawing No: 90.105.177

Grid lines: A, B, C, D, E, F, G, H, J, K, L, M, N, P, Q, R, S, T, U, V, W, X, Y, Z

HGP Greenlee Alchurch Evans Limited
Furzehall Farm, Wickham Road, Fareham, Hampshire, PO16 7JH, England
Tel: 01329 283225 Fax: 01329 237004 Email: email@hgp-architects.co.uk

